



**INSPECTION FOR INSTALLATION AND OPERATION OF HOUSEHOLD SEWAGE DISPOSAL SYSTEM**  
**Portage County Combined General Health District**  
**449 South Meridian St., Ravenna, OH 44266**  
**Phone: 330-296-9919 Fax: 330-297-3597**

Number: #04350 Update

Fee Paid: \$350.00

Date: 11/19/04

**THIS INSTALLATION PERMIT EXPIRES ONE YEAR FROM THE ABOVE DATE**  
**THIS OPERATION PERMIT GOES INTO EFFECT WHEN INSTALLATION IS APPROVED**

Permission is hereby granted to:

Owner's Name: **Richard Roberts**

Present Complete Mailing Address: P.O. Box 411, Wayland, OH 44285 Phone Number: (330) 358-2798

Location – Number & Street: **6230 Wayland Road** City/Township/Village: **Paris**

Date Backhoe Test Approved : 10/13/04 Approved By: S. Carlisle, R.S. Acreage: .50

Approved for: **Single Family** # of Bedrooms: **3**

**System Description:**

**2-1,000 gallon septic tanks & 450 lineal feet leaching tile in two equal fields. Design to contour. System should be graded & seeded as soon as possible. See attached specs & final inspection request form.**

*Shqg/cv*

These requirements for your septic system are minimum requirements of the Portage County Health Department and are not a guarantee of the future performance of the home sewage system. The system design has been developed by knowledge obtained from soil test(s) in a specific area of your lot at a specific point in time and may not reflect all conditions that may effect future performance of your sewage disposal system. Therefore, questions concerning the adequacy of your septic system should be directed to your system installer and are not the responsibility of the Health Department. **(THIS PERMIT IS NOT INTENDED FOR COMMERCIAL USE.)**

Final Inspection By: *Stan Carlisle, R.S.* Date: 11/4/05

Approved By: *Stan Carlisle, R.S.* Disapproved By: \_\_\_\_\_

Note: Individual household sewage systems are not a highly efficient method of sewage treatment. Any failure to provide or properly maintain such a system or to discharge all the sewage from the premises into the disposal system may be declared a public health nuisance by the Health Commissioner.

No household sewage disposal device or equipment shall be installed, maintained or operated on property accessible to a sanitary sewerage system.

*Fred Shaulis*  
 APPLICANT'S SIGNATURE  
 Fred Shaulis/Shaulis Contracting  
 Mailed video to owner

*K.F. Ruff, M.D.*  
 HEALTH COMMISSIONER

*This agency is an equal provider of services and an equal employment opportunity employer – Civil Rights Act 1964 (CRA)*





**REQUIREMENTS FOR SEWAGE DISPOSAL SYSTEM**

04-350

Portage County Combined General Health District  
449 South Meridian St., Ravenna, OH 44266

(Phone # 330-296-9919)

Richard Roberts P.O. Box 411, Wayland, OH 44288 358-2798  
Owner's Name Present Address Phone No.

6230 Wayland Rd Paris  
Location - Number & Street Township/Village

10/12/04 SC per test hole w/ Fred Shultz 0.500  
Date Approved Approved By Acreage

APPROVED FOR: Single Family X Duplex \_\_\_\_\_ Triplex \_\_\_\_\_ # of Bedrooms 3

1.  2-1,000 Gallon Septic Tanks & 450 Lineal Feet Leaching Tile in Two Equal Fields.
2.  2-1,000 Gallon Septic Tanks & \_\_\_\_\_ 1,000 Gallon Leaching Wells.
3.  2-1,000 Gallon Septic Tanks & \_\_\_\_\_ Lineal Feet Evapotranspiration Trenches in Two Equal Fields & a Curtain Drain.
4.  Class I Failsafe Aeration System with Sample Box & Chlorinator.
5.  Other, See Comment Section Below:

COMMENTS: See attached specs  
\_\_\_\_\_  
\_\_\_\_\_  
\_\_\_\_\_  
\_\_\_\_\_

**These requirements for your septic system are minimum requirements of the Portage County Health Department and are not a guarantee of the future performance of the home sewage system. The system design has been developed by knowledge obtained from soil test(s) in a specific area of your lot at a specific point in time and may not reflect all conditions that may effect future performance of your sewage disposal system. Therefore, questions concerning the adequacy of your septic system should be directed to your system installer and are not the responsibility of the Health Department.**

**BASIC SYSTEM DESIGN (MAY NOT INDICATE ACTUAL DESIGN) (SUMP PUMP MAY BE REQUIRED)  
(MUST BE DESIGNED TO CONTOUR)**

*Installer to determine best lay out*

RECEIVED

OCT 13 2004

Richard + Debra Roberts

6206 Wayland Rd

Part - Wayland 03 442ft

0.500 Acres

Lot 2406

JBR

Met Fred Skelton for test hole

Nothing on site

10/12/04

Appears An

Res.  $\approx$  -1000

450' LT

SL

10/22/04

Fred said


he laid out

475'

OK

for trench

SL

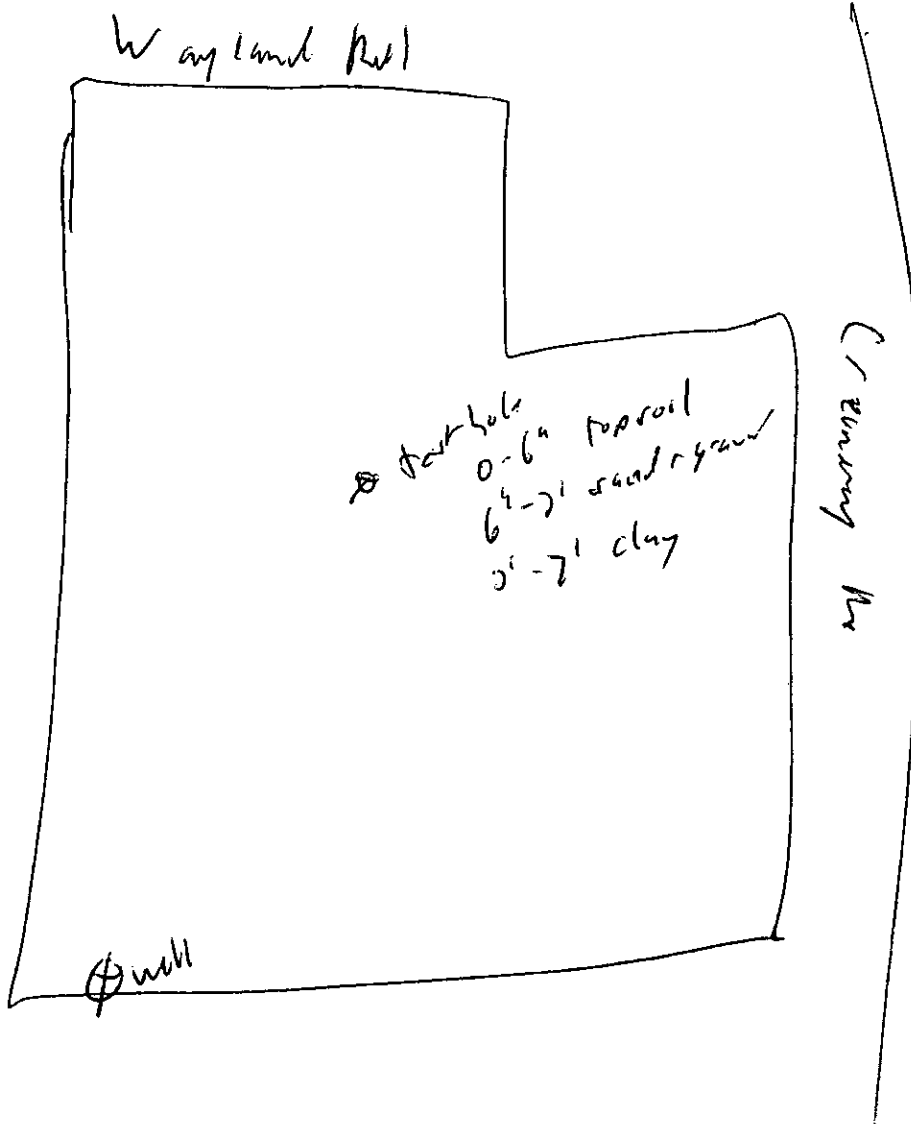



# REQUIREMENTS FOR SEWAGE DISPOSAL SYSTEM

Portage County Combined General Health District  
449 South Meridian St., Ravenna, OH 44266

(Phone # 330-296-9919)

Roberts, Richard  
Owner's Name

PO Box 411, Wayland, OH 44285  
Present Address

Phone No.

6230 Wayland Rd.  
Location - Number & Street

Paris  
Township/Village

10-4-04  
Date Approved

KW  
Approved By

.5  
Acreage


APPROVED FOR: Single Family  Duplex \_\_\_\_\_ Triplex \_\_\_\_\_ # of Bedrooms 3

1.  2-1,000 Gallon Septic Tanks & \_\_\_\_\_ Lineal Feet Leaching Tile in Two Equal Fields.
2.  2-1,000 Gallon Septic Tanks & \_\_\_\_\_ 1,000 Gallon Leaching Wells.
3.  2-1,000 Gallon Septic Tanks & \_\_\_\_\_ Lineal Feet Evapotranspiration Trenches in Two Equal Fields & a Curtain Drain.
4.  Class I Failsafe Aeration System with Sample Box & Chlorinator, and Dechlorinator.
5.  Other, See Comment Section Below.

COMMENTS: Discharge to existing discharge line on property. Pump, crush, and fill existing tanks. An annual inspection fee is required if a service contract is not maintained.

**These requirements for your septic system are minimum requirements of the Portage County Health Department and are not a guarantee of the future performance of the home sewage system. The system design has been developed by knowledge obtained from soil test(s) in a specific area of your lot at a specific point in time and may not reflect all conditions that may effect future performance of your sewage disposal system. Therefore, questions concerning the adequacy of your septic system should be directed to your system installer and are not the responsibility of the Health Department.**

BASIC SYSTEM DESIGN (MAY NOT INDICATE ACTUAL DESIGN) (SUMP PUMP MAY BE REQUIRED)  
(MUST BE DESIGNED TO CONTOUR)

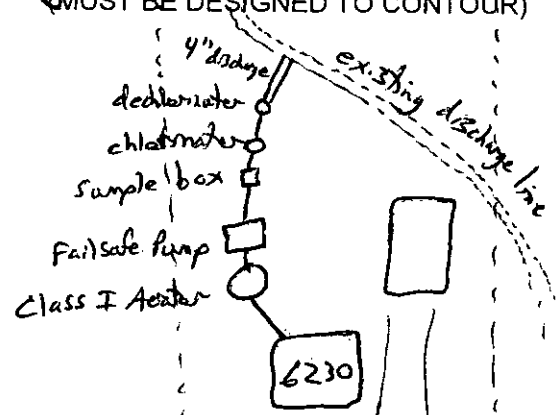

9204 Newton Falls Rd Ravenna OH 44266  
Phone 330-358-2287  
Fax 330-358-2207



# Fax

To: Stan From: Fred  
 Fax: 297-3597 Pages: 1 Plus Cover Sheet  
 Phone: 296-9919 Date: 1-3-05  
 Re: \_\_\_\_\_ CC: \_\_\_\_\_

- Urgent     For Review     Please Comment     Please Reply     Please Recycle

● Comments:

System ready for inspection  
when you have a chance

330-358-2287 office  
330-958-3415 cell phone

Thanks

Fred Shaulis

Sewer line at house

OK

Sewer line at outlet of 2nd tank

OK

Sewer line at 1st tank inlet

Top of 1st elbow in top field

Trench #	Box?	Elbow?	Show box location			
			Laser shots of top of pipe in trench, curtain drain and sewer lines.			
1	ye	ye		5'8"		5'10"
2	ye	ye		6'2"		6'2"
3	ye	ye	6'2"			6'3"
4	ye	ye	6'5"			6'5"
5	ye	no	6'8"			6'6"
6	ye	ye	7'4"			7'6"
7	ye	ye	7'10"			8'0"
8	ye	ye	7'11"			7'11"
9	ye	no	8'4"	8'4"		8'4"
10						
11						
12						
13						
14						
15						
16						
17						

Curtain drain exit

NA

Portage County Health Department  
449 S. Meridian Street  
Ravenna, OH 44266

Phone: (330-296-9919)  
Fax: (330-297-3597)

Name Robert Installer Name S. S. S. S.  
Address 6230 Wayland Rd Installer Phone 358-2287  
Township Paris Cell Phone 958-3415 ✓

Water Well Distance Back - OK Property Lines OK Right-of-Ways none seen

Sewer Line Type 5.5 40 Slope OK OK

First Tank Size 1000 Inlet Baffle concrete Tank Level yes Outlet Baffle OK Riser 12"  
Second Tank Size 1000 Inlet Baffle OK Tank Level yes Outlet Baffle plastic Riser 12"

Line from second tank to splitter box OK Splitter Elbow OK

Type of secondary system 450 ET of Leach lines or SB2 or Infiltrator or other \_\_\_\_\_

Depth of gravel 12" Height of lower sideway 4-12" Size of Gravel 57

Width of trench 18" Depth of trench 16"-24" Distance apart 6'

Distance from curtain drain NA Depth of curtain drain on top NA

Depth of curtain drain at exit point NA Correct fall throughout system yes

Straw covering trenches OK

Any sump pump from tanks no If so, has pump been installed NA

Any sump pump for curtain drain NA If so, has pump been installed NA

If aeration system, what brand NA Failsafe NA Inspection port NA

Chlorinator NA Discharge point NA Dechlorinator NA

SB Longitude 41° 09.584 N Latitude 081° 04.232 W Elevation 957 ft.

Tank Longitude 41° 09.588 N Latitude 081° 04.244 W Elevation \_\_\_\_\_ ft.

Is all wash (grey and black) water going into septic? yes

Is any footer drain, sump pump, garage drain, softener discharge, etc. (clearwater) going into septic? no per owner

Comments: \_\_\_\_\_  
\_\_\_\_\_  
\_\_\_\_\_

Inspector [Signature] Date 11/4/05  
Green  Tag left on 1st 2nd tank riser or pump chamber or splitter box or other \_\_\_\_\_  
Yellow   
Red  Home owner